


front


side

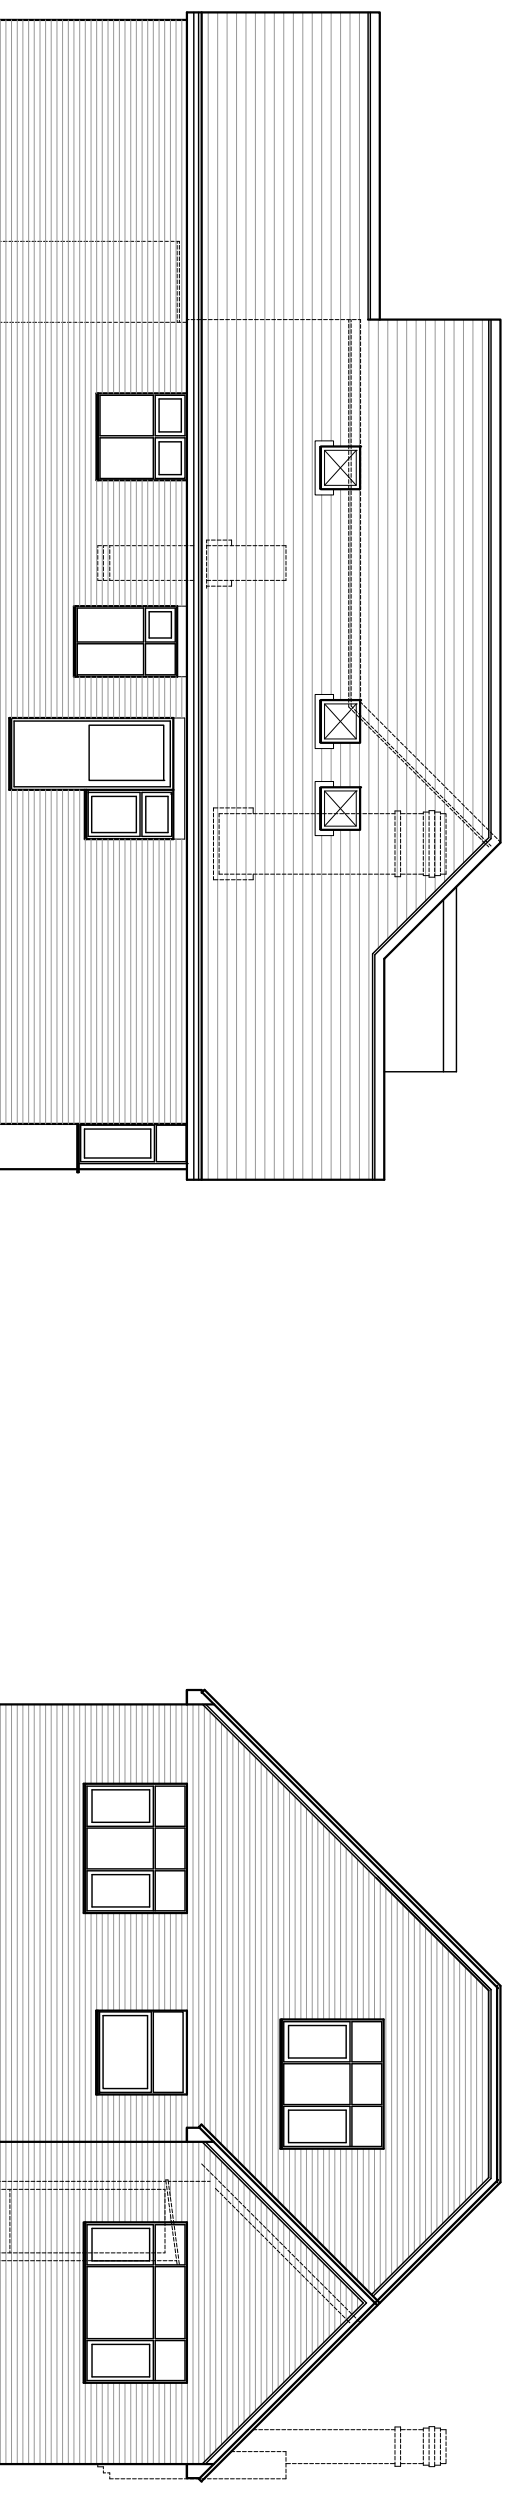


side

rear

**PROPOSED**

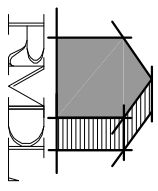

**RAMMURTI DESIGN LTD**  
 ARCHITECTURAL & PLANNING SERVICES  
 268 TILFHURST ROAD, READING RG30 2NE  
 TEL/FAX: 01189510628 MOB: 077998883574

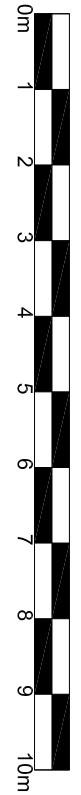

Proposed split of recently extended bungalow to 2No apartments  
 of 3bedroom and 1bedroom  
 at 34 Hilltop Road, Reading  
 for Mr J Singh

**AS BUILT AND AS PROPOSED ELEVATIONS**  
 Scale: 1/100 @A3 drawing  
 Date: December 2020 **HTR:606 Rev A**

This page is intentionally left blank