




Accommodation schedule
Ground floor Unit (area 104m²) 3bedrooms 2No washrooms
First floor Unit (area 55m²) 1bedroom 1 washroom

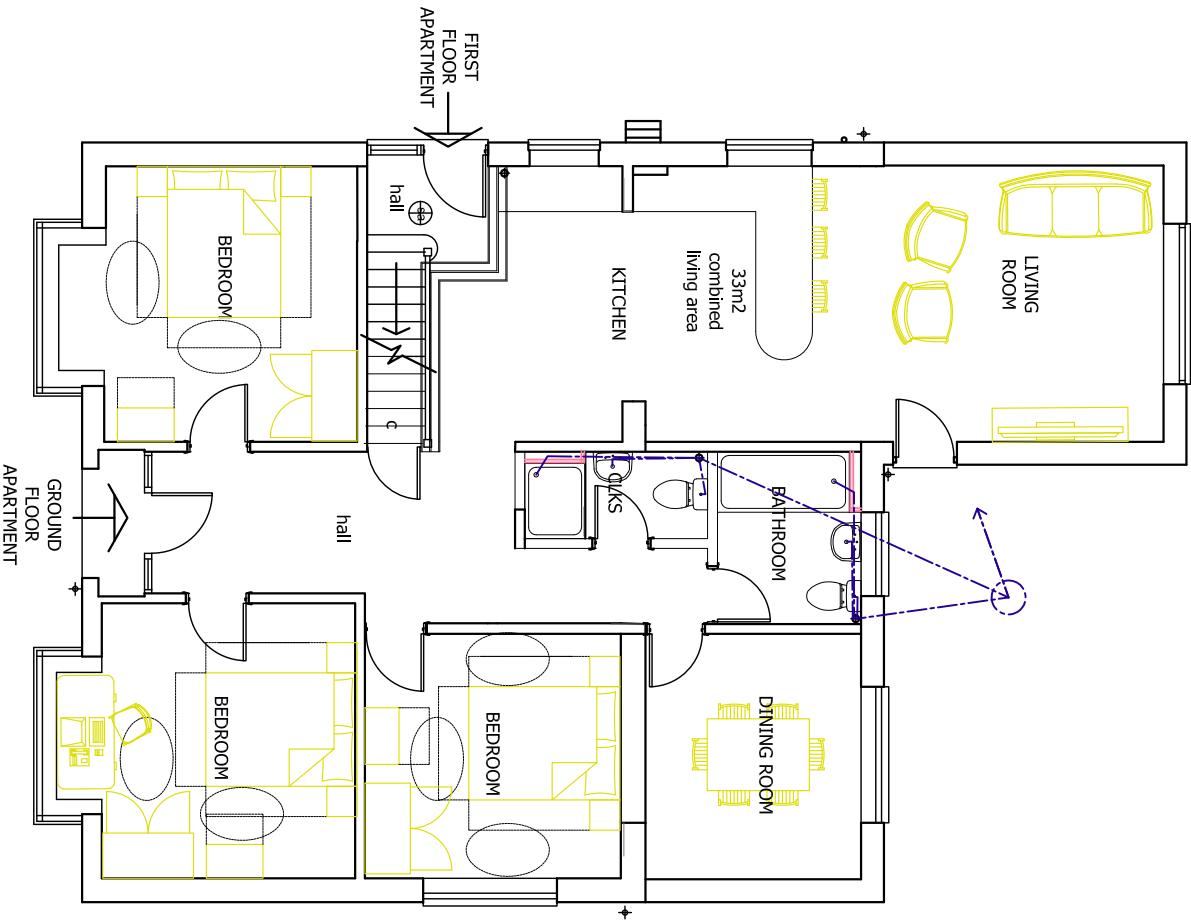



Ground Floor Plan

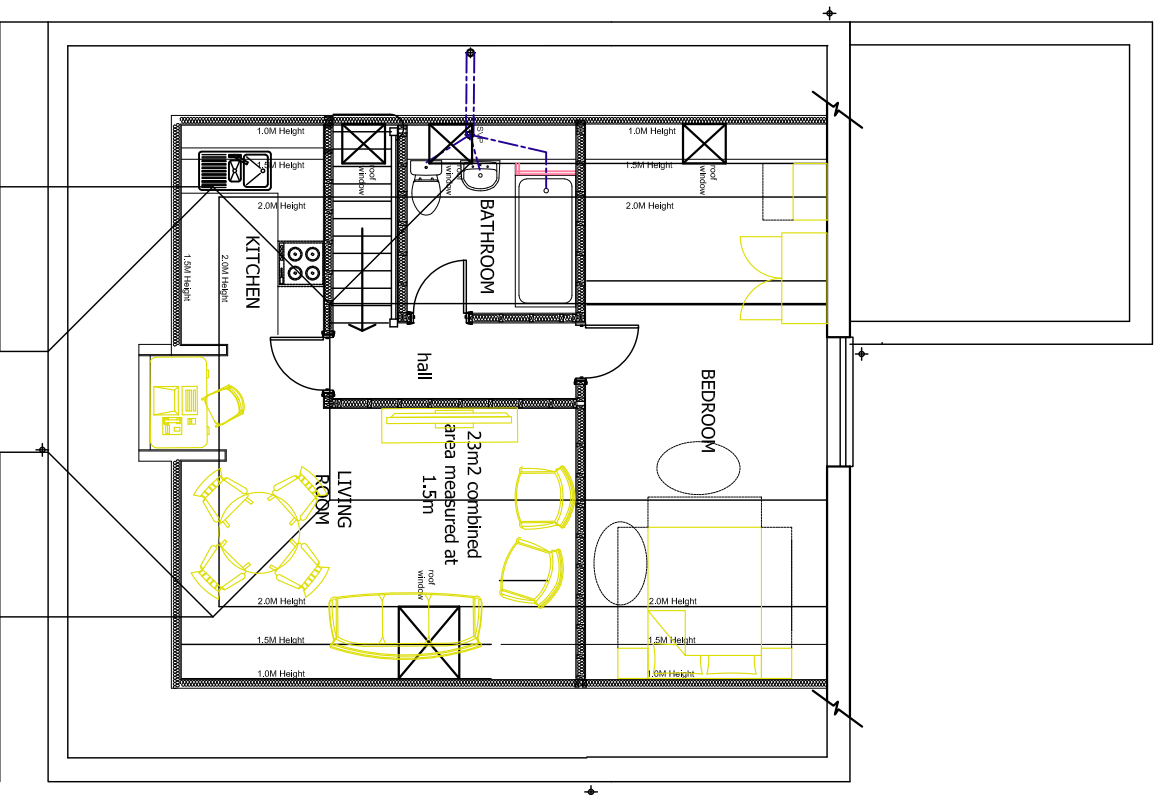

Loft Floor Plan

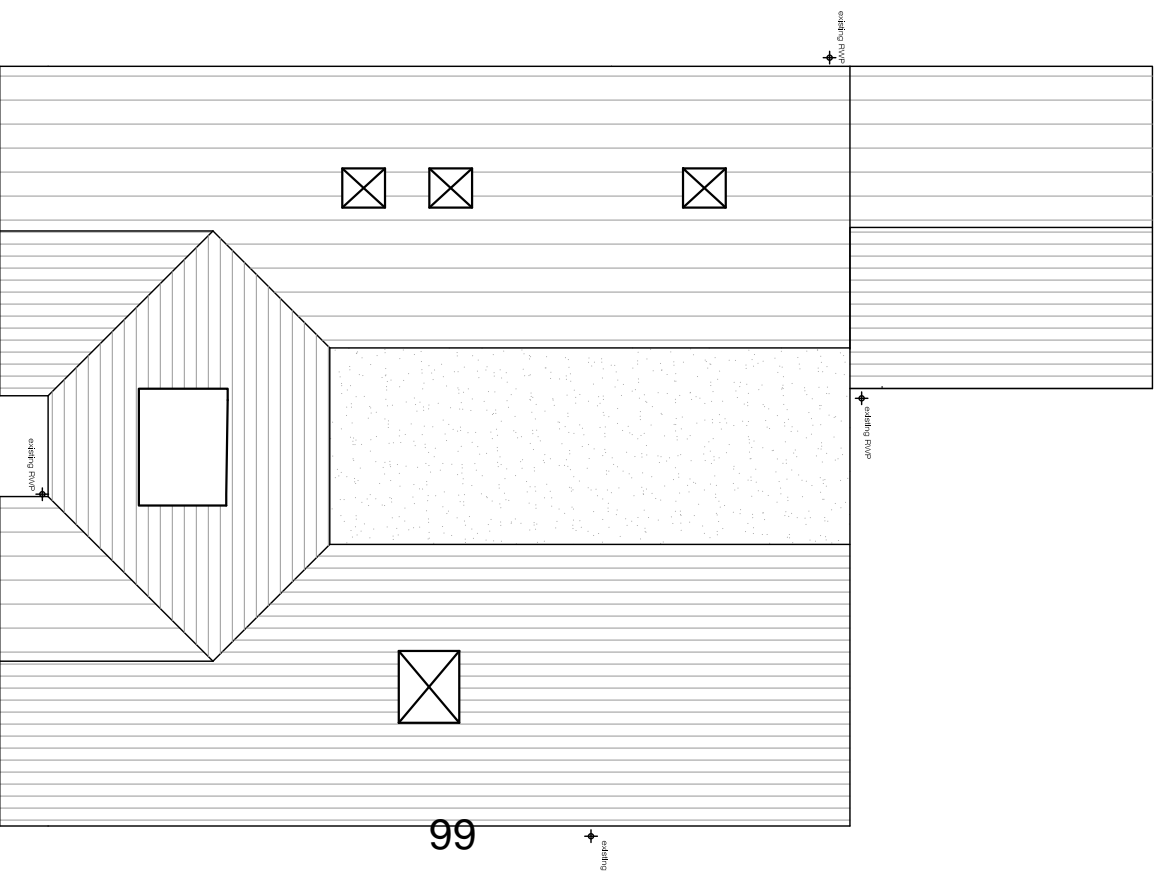

Roof Plan

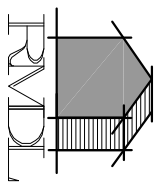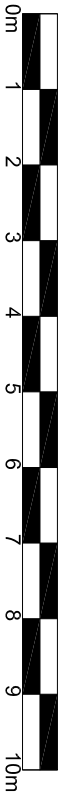

RAMMURTI DESIGN LTD
 ARCHITECTURAL & PLANNING SERVICES
 268 TILFHURST ROAD, READING RG30 2NE
 TEL/FAX: 01189510628 MOB: 077998883574

Proposed split of recently extended bungalow to 2No apartments
 of 3bedroom and 1bedroom
 at 34 Hilltop Road, Reading
 for Mr J Singh

AS-BUILT AND AS PROPOSED FLOOR PLANS
 Scale: 1/100 @ A3 drawing
 Date: December 2020
HTR:605 Rev -

This page is intentionally left blank