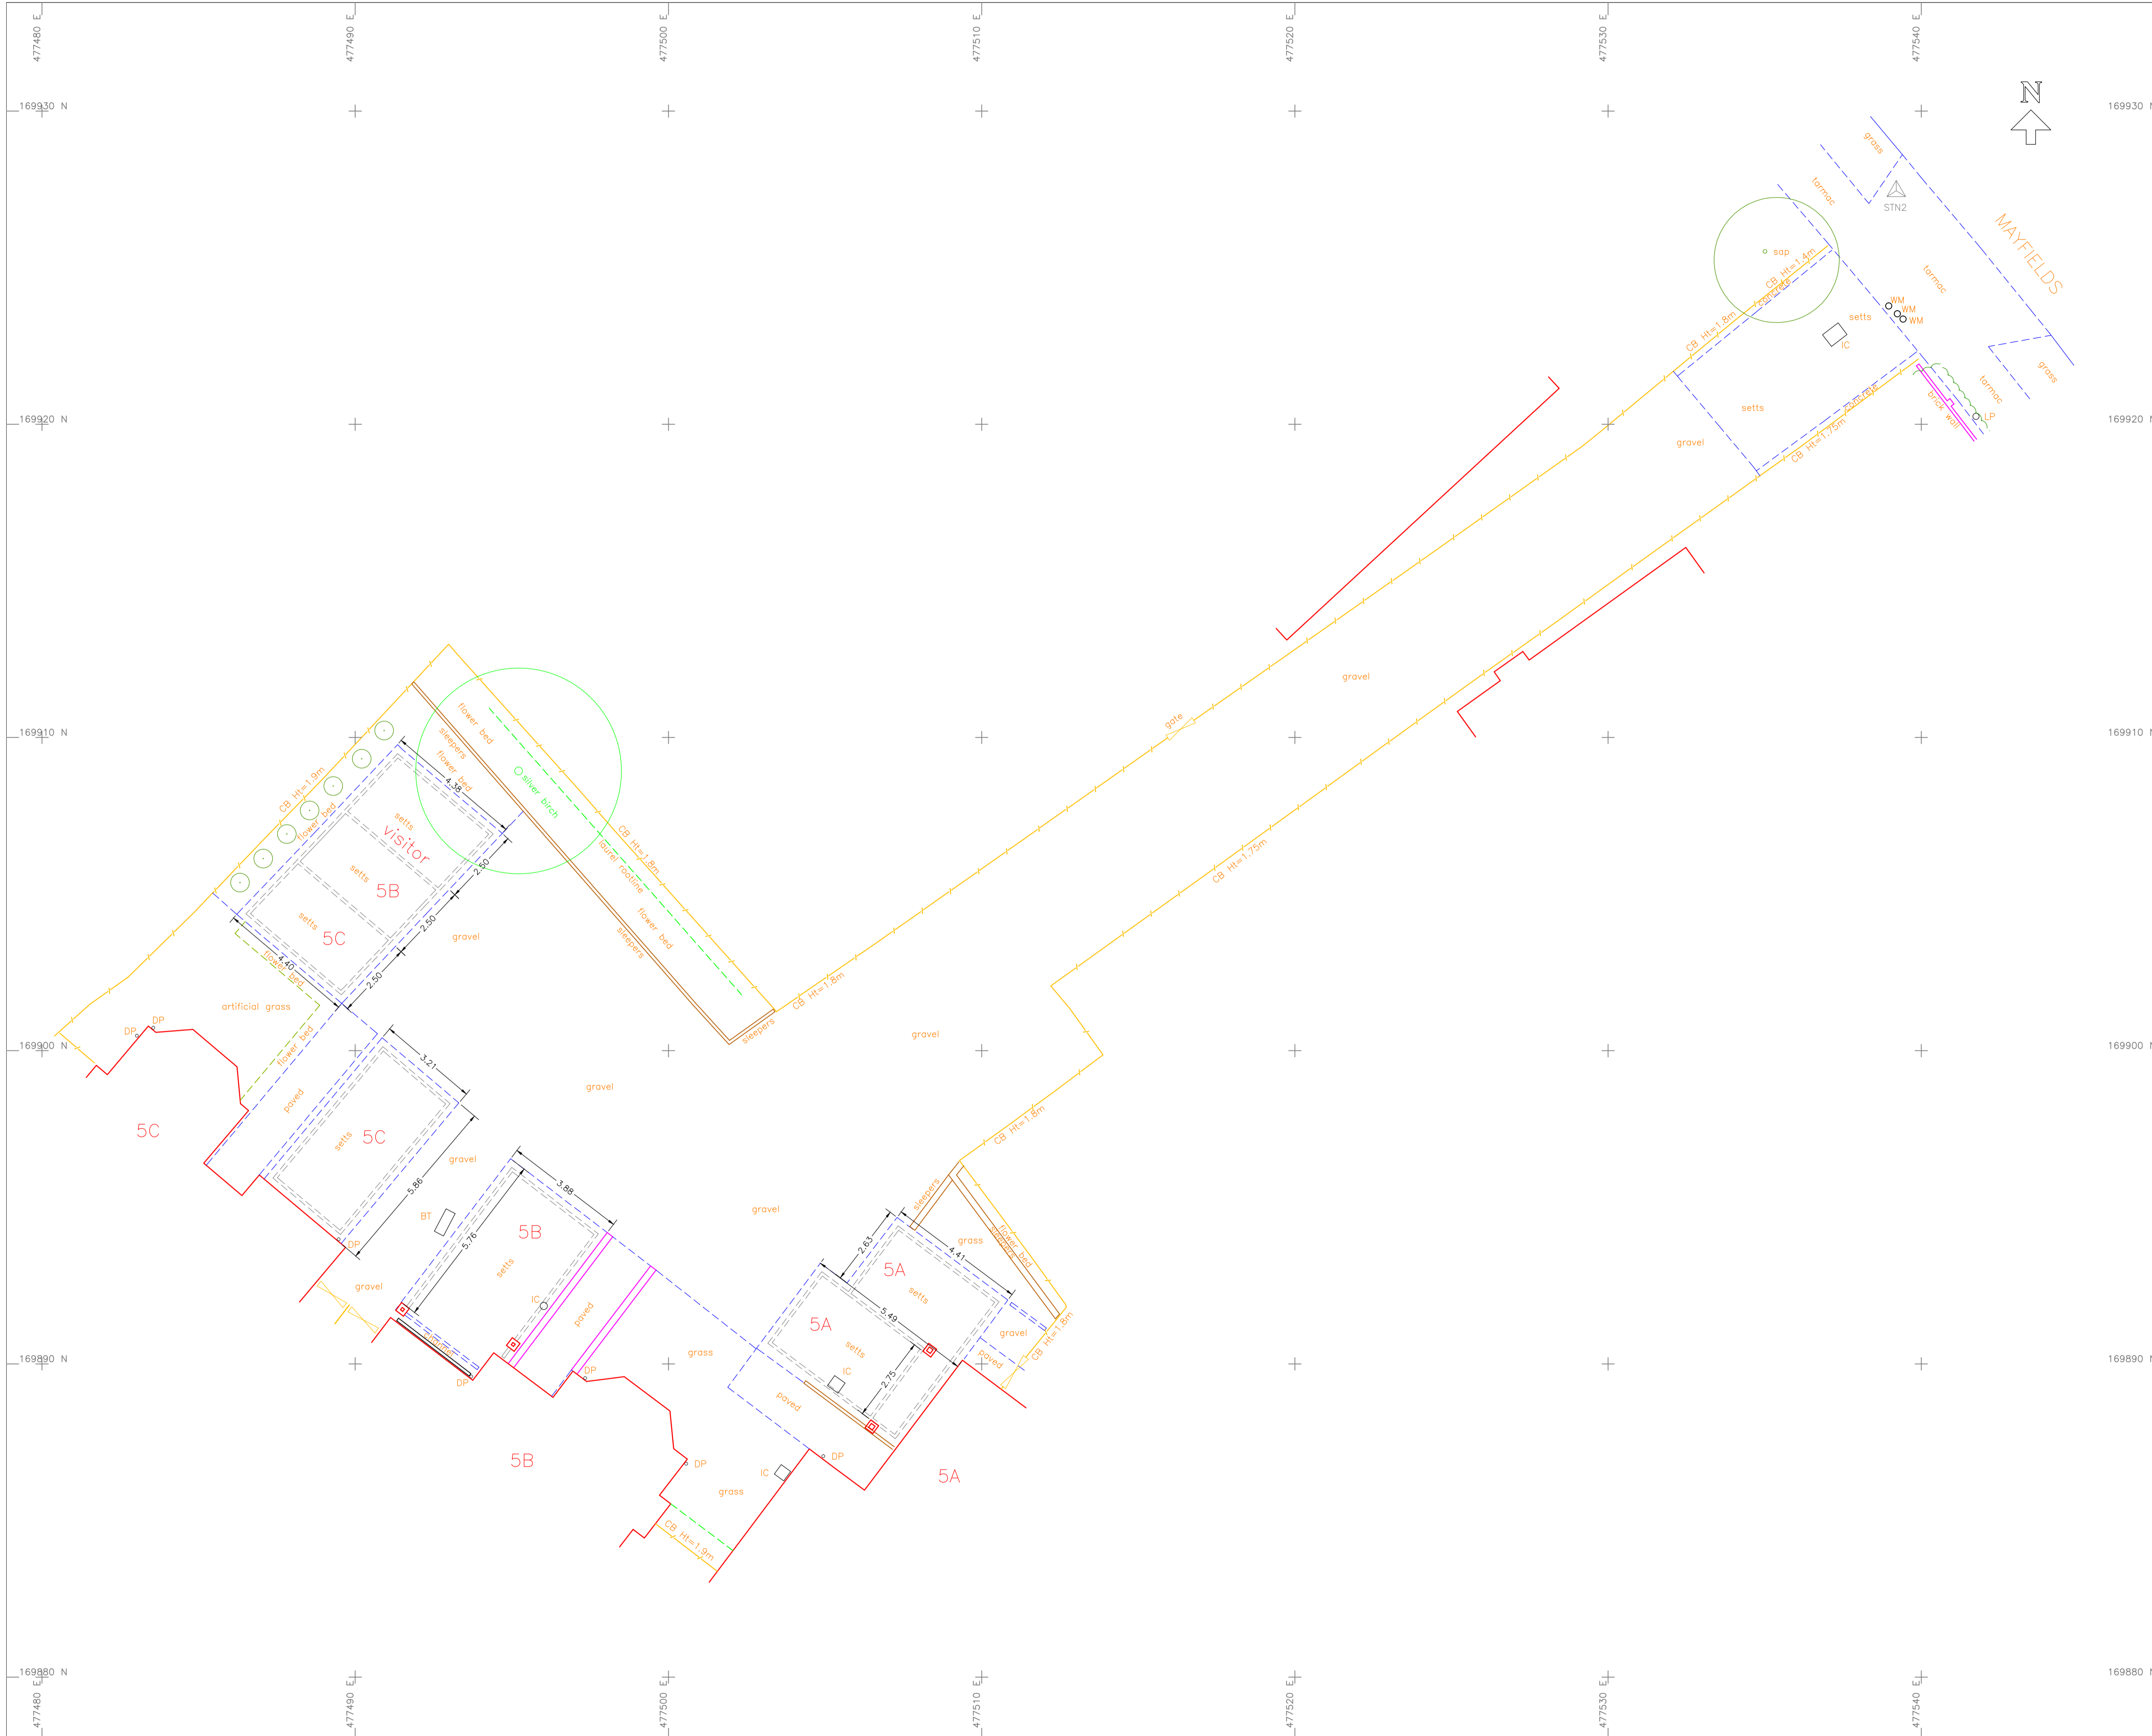


50.00m

| | | |
|---|------------------------|-------------------|
| SITE 5A, 5B, 5C MAYFIELDS SINDLESHAM BERKSHIRE RG41 5BY | TITLE LOCATION PLAN | |
| | SCALE 1/1250 (A4) | DATE JULY 2022 |



LEGEND

| FEATURE STYLES | FEATURE ABBREVIATIONS |
|-------------------------|-----------------------|
| SURVEY CONTROL | AV Air Valve |
| FENCE | BS Bus Stop |
| HEDGE | BT British Telecom |
| FWS | BW Brick Wall |
| SWS | CB Conc Bollard |
| WATER | CL Cover Level |
| POWER LINE (OVERHEAD) | CTO cable TV outlet |
| TELECOM LINE (OVERHEAD) | EB Electric Box |
| GAS MAIN | EC Electric Cover |
| EMBANKMENT | EP Electricity Pole |
| | FH Fire Hydrant |
| | FL Floor level |
| | G Gully |
| | GM Gas Meter |
| | GV Gas Valve |
| | IL Invert Level |
| | IC Inspection Chamber |
| | KLS Keep Left Sign |
| | KD Kerb Duffet |
| | LB Letter Box |
| | LP Lamp Post |
| | MKR Marker |
| | MP Metal Post |
| | MH Manhole |
| | MB Metal Bollard |
| | P Post |
| | PI Petrol Interceptor |
| | RG Road Gully |
| | RNB Road Name Board |
| | RS Road Sign |
| | RW Retaining Wall |
| | SA Sockaway |
| | SC Stopcock |
| | SV Sluice Valve |
| | TP Telegraph Pole |
| | TCB Telephone Box |
| | TJB TelJunc.Box |
| | TL Traffic Light |
| | V Valve |
| | VP Vent Pipe |
| | WL Water Level |
| | WM Water Meter |
| | WO Water Outlet |
| | WV Water Valve |

DATUM
GRID - ORDNANCE SURVEY NATIONAL GRID (OSTN15)
SCALE FACTOR REMOVED

| SURVEY CONTROL | | | |
|----------------|------------|------------|--------|
| STN | -E- | -N- | -Z- |
| 1 | 477566.672 | 169941.061 | 52.731 |
| 2 | 477539.201 | 169927.455 | 52.848 |

NOTES
Drainage and service covers that were buried, obscured or not visible at the time of the survey cannot be shown. Sewer connections between manholes are assumed to be straight and only pipes visible from the cover are shown. Tree canopy measured values are written as maximum spreads. Tree species/condition to be verified by arboriculturist.

Moon Geospatial Ltd
Land & Engineering Surveyors

T: 0773 3321449
e: office@moongeospatial.com
www.moongeospatial.com

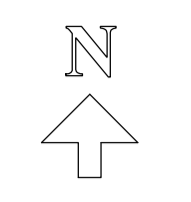
CLIENT
MR J BRUNT

SITE
5a, 5b, 5c MAYFIELDS
SINDLESHAM
BERKSHIRE
RG41 5BY

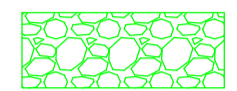
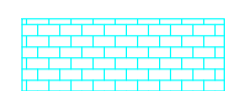
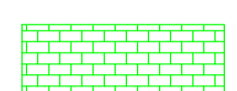

TITLE
AS BUILT SURVEY
AS EXISTING

| | | | |
|-------------|------------|---------|-----------|
| SCALE | 1/100 (A1) | DATE | JUNE 2022 |
| DRAWING No. | 01 | JOB No. | 22061598 |

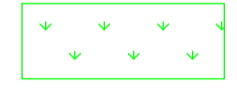
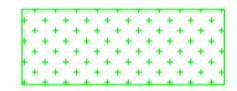
LANDSCAPING PLAN
 5a, 5b, 5c MAYFIELDS
 SINDLESHAM
 BERKSHIRE
 RG41 5BY



HARDWORKS

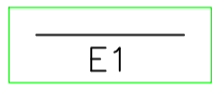
-  CRUSHED COTSWOLD STONE
-  BLOCK PAVING
 Manufacturer: Brodstone
 Product: Woburn Original
 Laying pattern: Runner Bond
 Size: 200x134
-  BLOCK PAVING
 Manufacturer: Brodstone
 Product: Woburn Rustic
 Laying pattern: Runner Bond
 Size: 200x134
-  BLOCK PAVING
 Manufacturer: Brodstone
 Product: Woburn Rustic
 Laying pattern: Runner Bond
 Size: Mixed

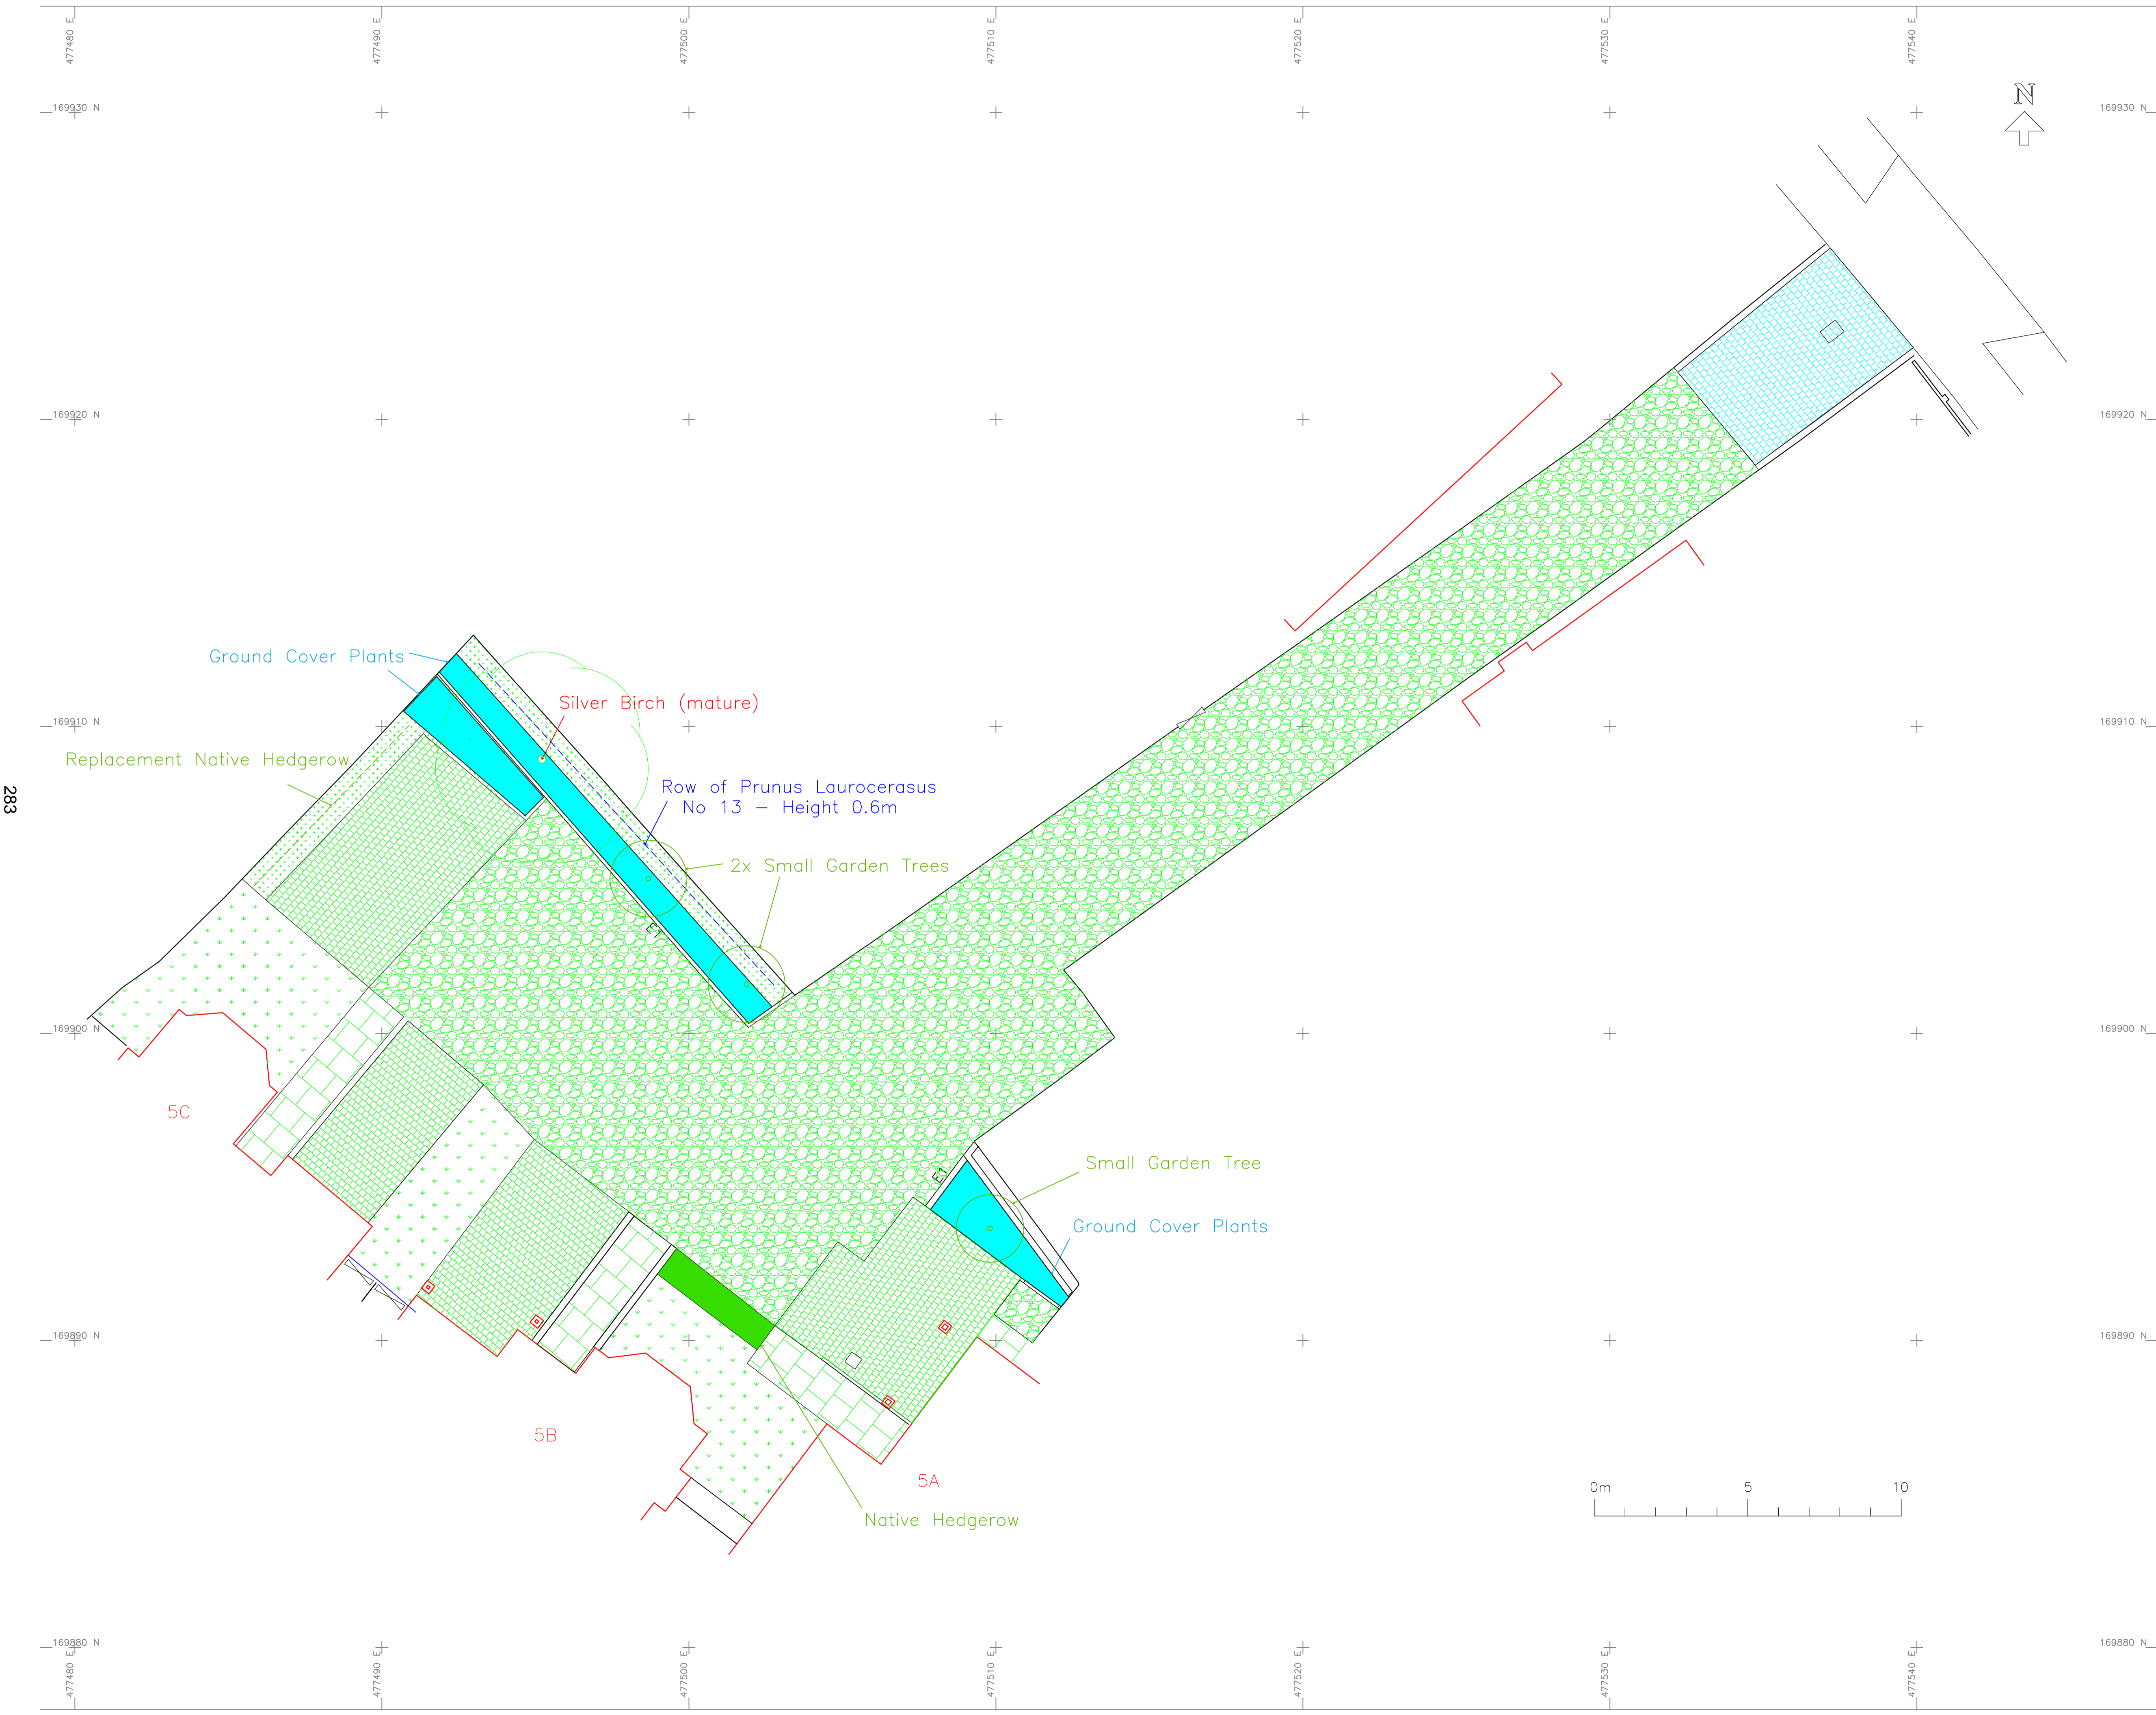
SOFT LANDSCAPING

-  GRASS
-  SHRUB PLANTING
 Planting Specification:
 Laurel, Cypress, bedding plants

-  EXISTING TREE
 Species: Silver Birch

EDGING

-  Sleepers
 E1



283

SCALE 1/100 (A1)

This page is intentionally left blank