




FRONT ELEVATION - As Built  
 Scale 1:100

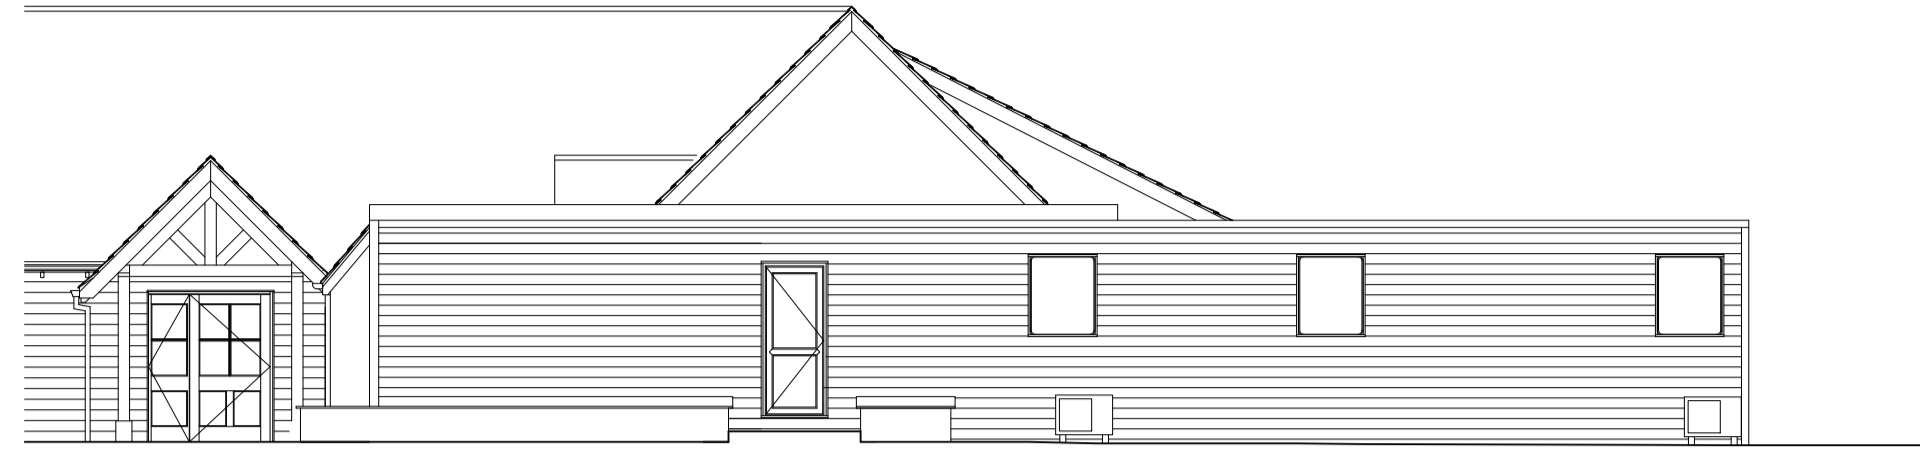


SIDE ELEVATION - As Built  
 Scale 1:100

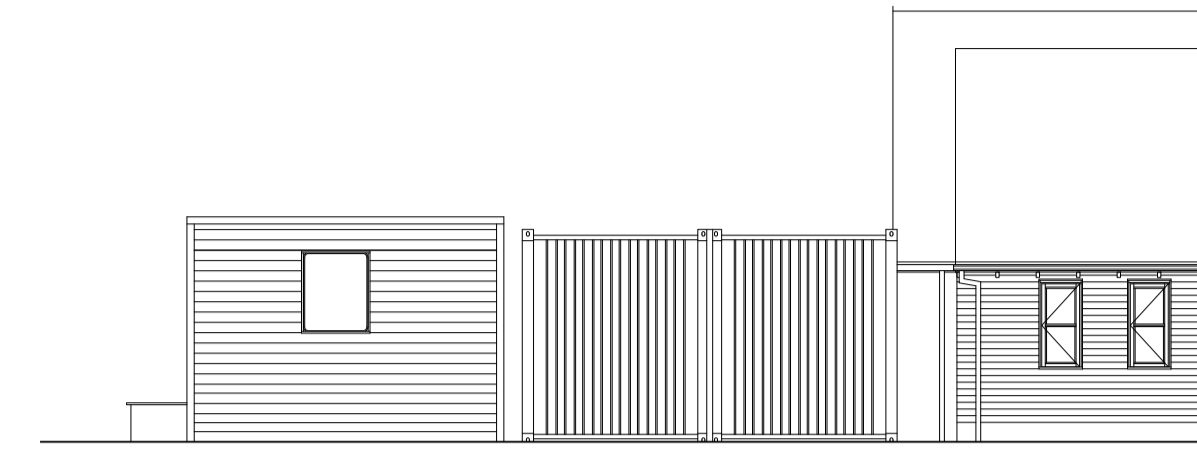


REAR ELEVATION - As Built  
 Scale 1:100

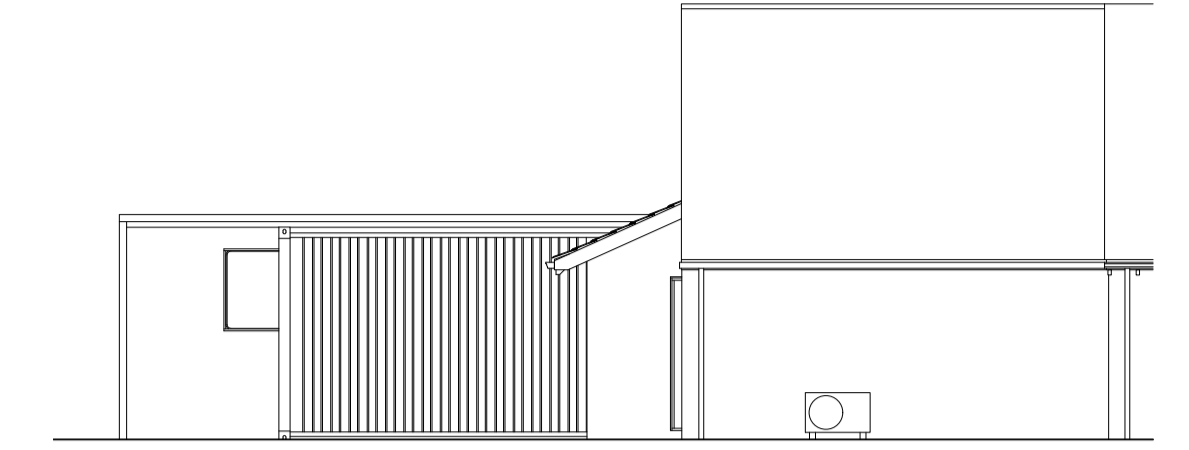


SIDE ELEVATION - As Built  
 Scale 1:100

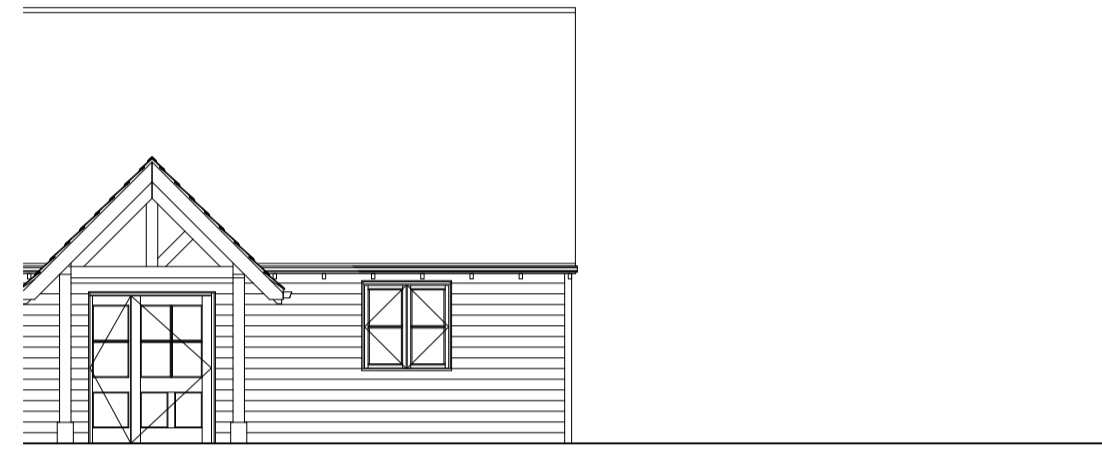


FRONT ELEVATION - As Original  
 Scale 1:100

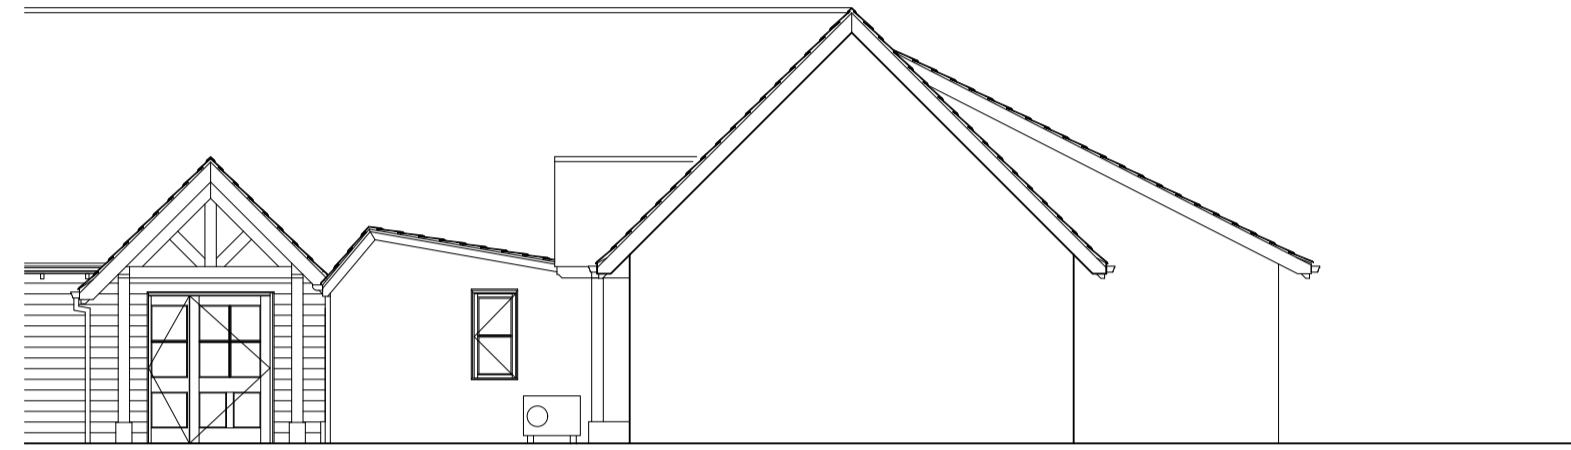


SIDE ELEVATION - As Original  
 Scale 1:100

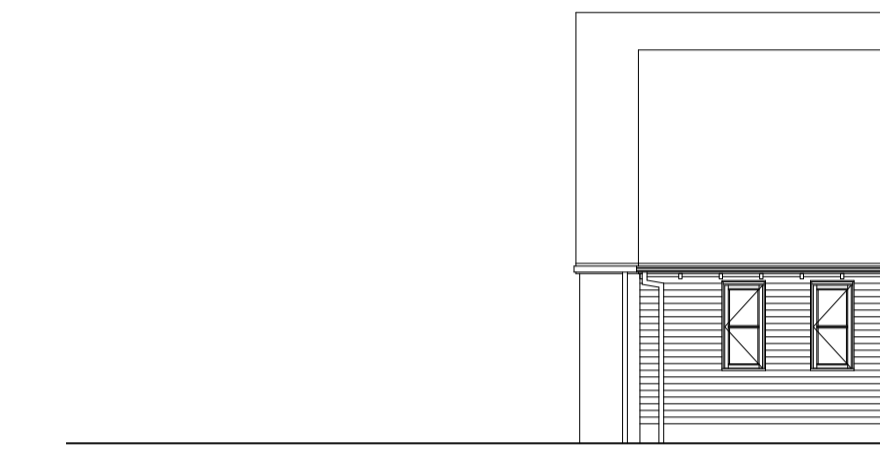


REAR ELEVATION - As Original  
 Scale 1:100

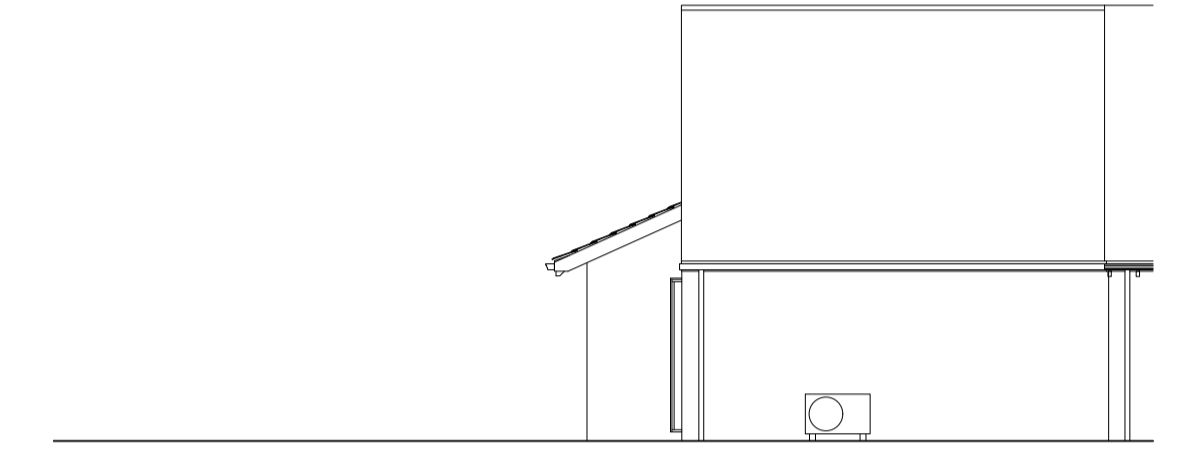



SIDE ELEVATION - As Original  
 Scale 1:100

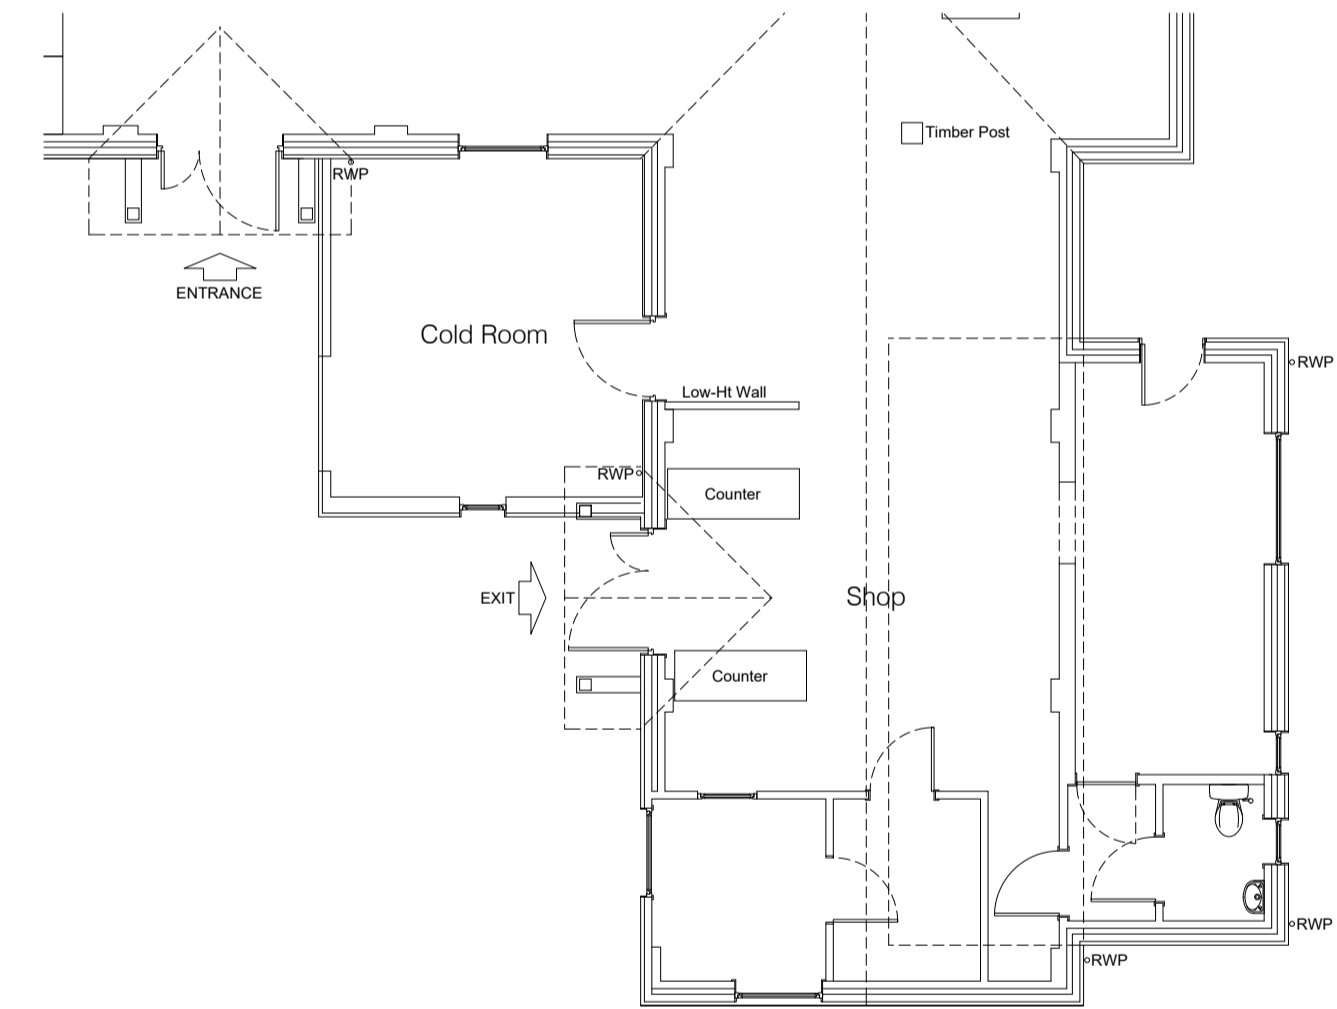

GROUND FLOOR PLAN - As Original  
 Scale 1:50

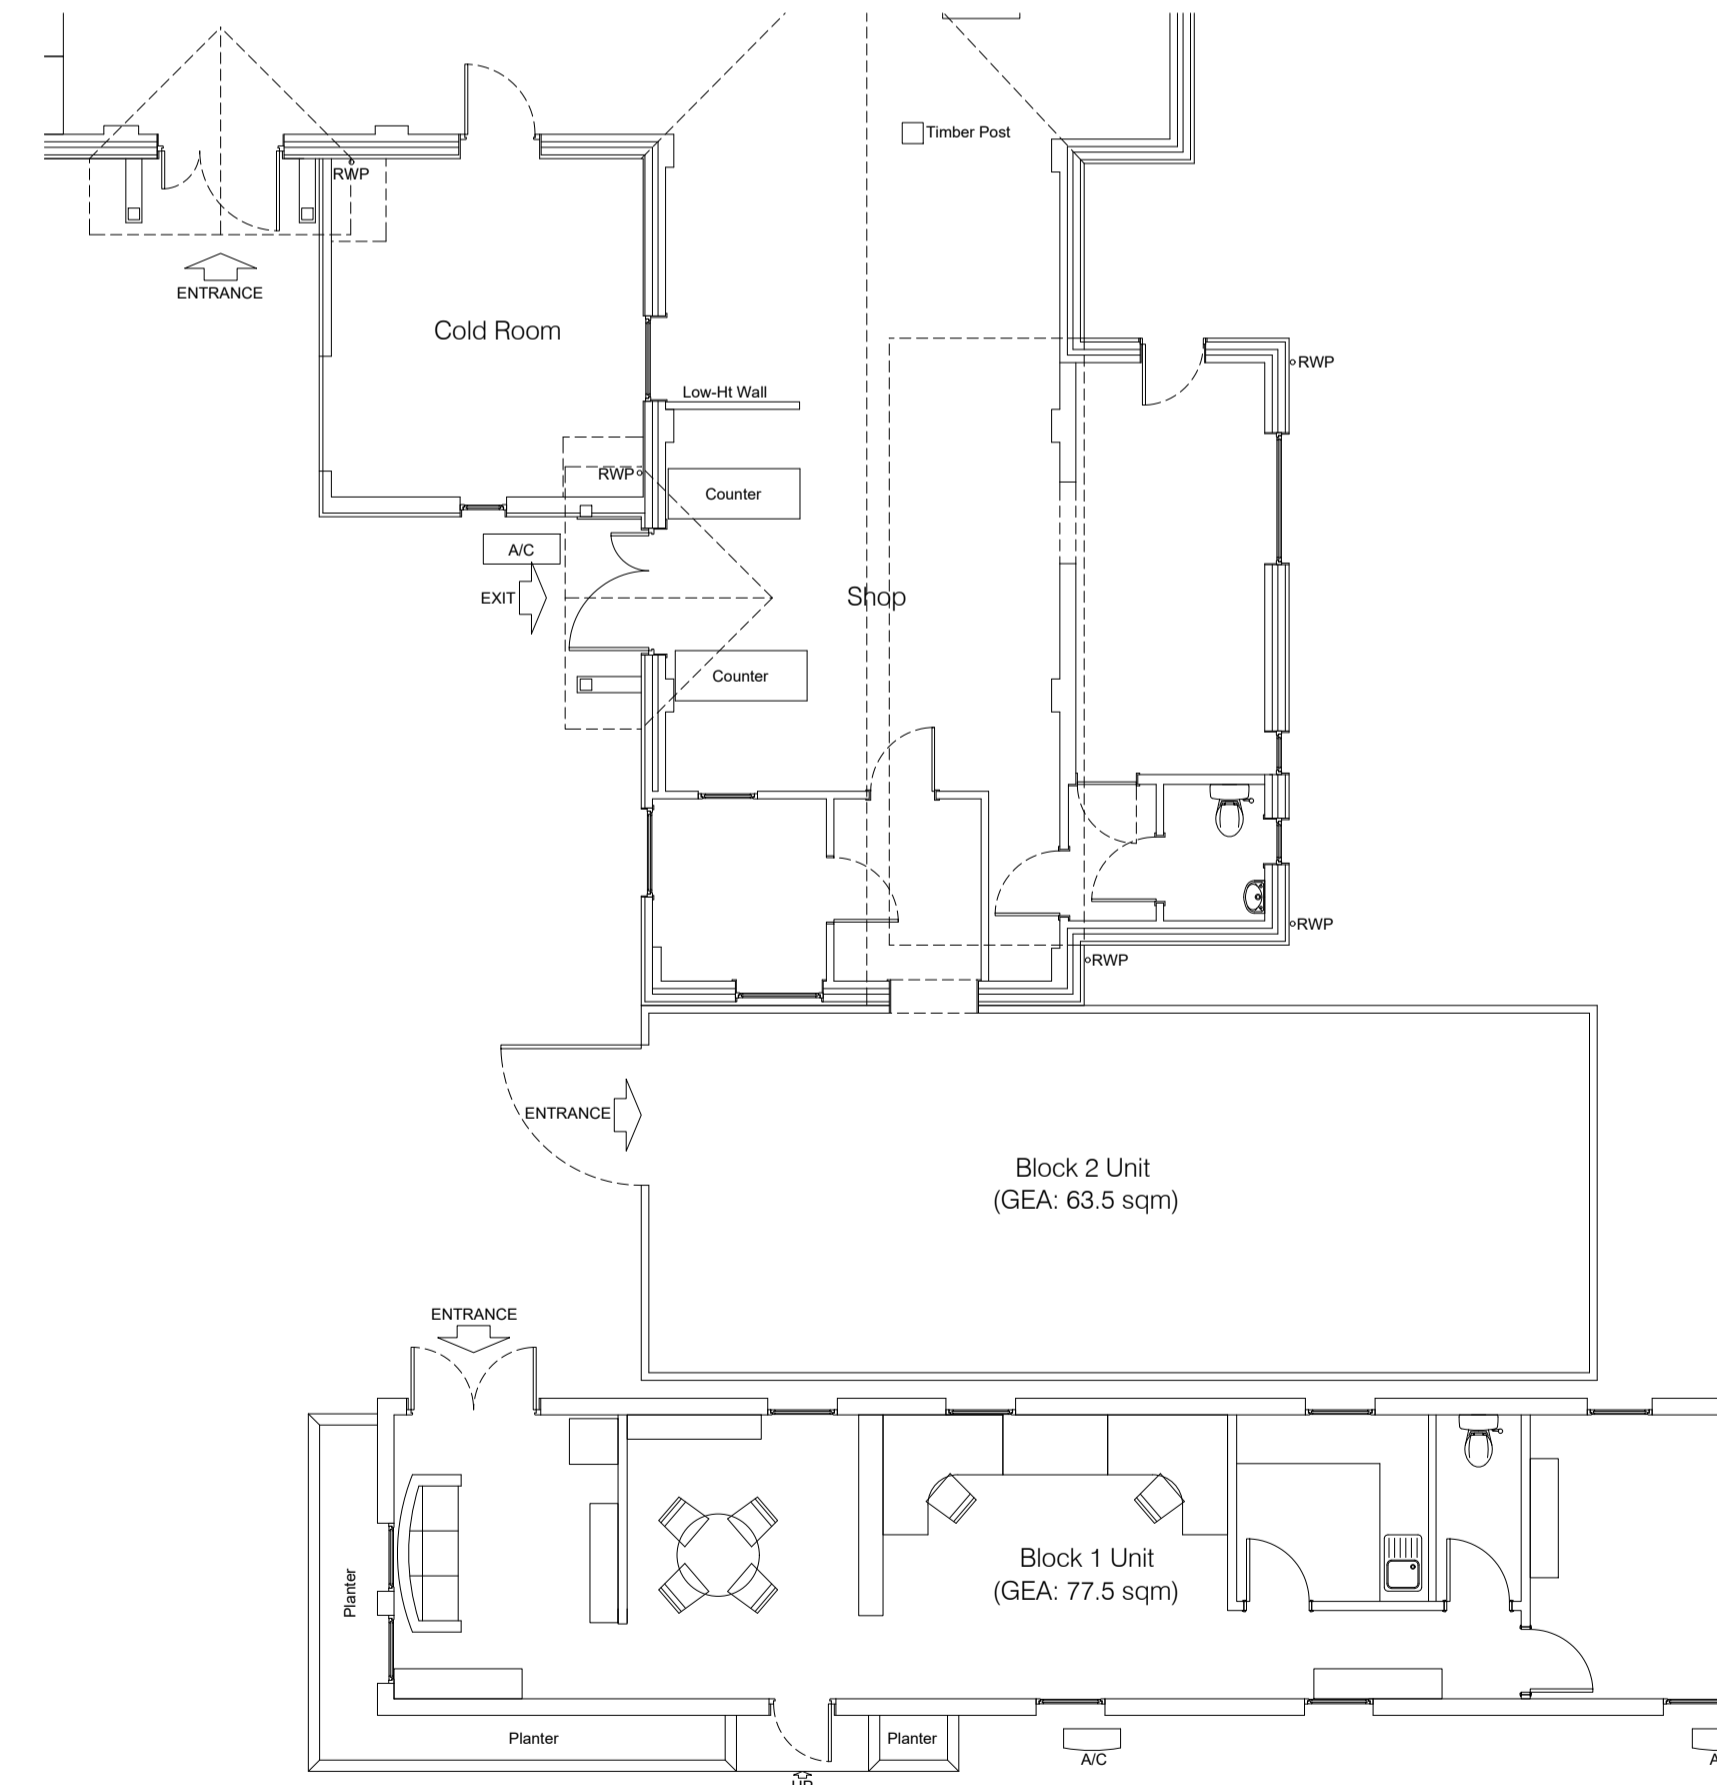

GROUND FLOOR PLAN - As Built  
 Scale 1:50

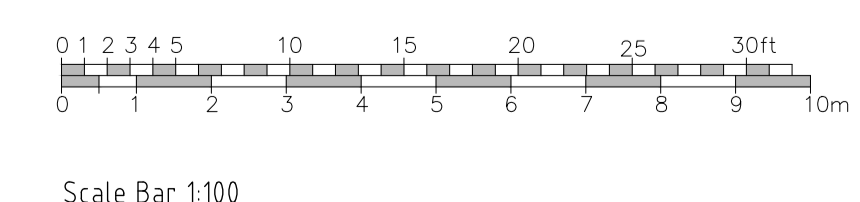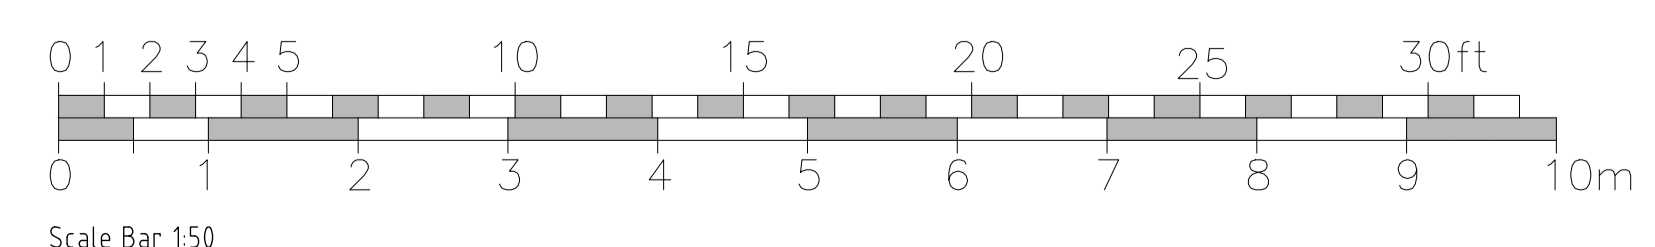

243

Rev	Description	Date	Initials
Status			
<b>HOLTHAM+NEWMAN</b> ARCHITECTS			
The Design Studio, Lockey Farm, Sindlesham Road, Arborfield, Reading, Berkshire RG2 9JH		T: 07971 316499 E: hello@hnrchitects.co.uk	
Project: - Lockey Farm Sindlesham Road, Arborfield Reading RG2 9JH			
Client Graham Adams			
Drawing Title: Ground Floor General Arrangement Plans Inc. External Elevations Denoting Blocks 1 and 2 As Original and As Built			
Scale:	Varies @ A1 Dwg. No.:	Rev.:	
Drawn by:	DH	2203-P123	P1
Date:	Dec 2022		

This page is intentionally left blank